


# JALA PAVILION BANQUET SEATING PLAN

SCALE 1:50

JALA PAVILION					
Length	10284mm	Doors	Stacking Doors, Double door	Cinema	225
Width	19220mm	Air-conditioning	Automatic	Banquet	150
Total Area	200m <sup>2</sup>	Light Intensity	0%-100% (pre-sets)	Banquet (Dancefloor)	130
Height	4600mm	Schoolroom	150	Cocktail	180

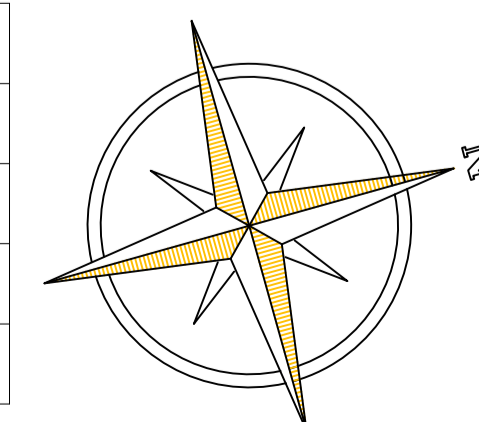

Rev	Description	Date
A	FOR INFORMATION	21.02.23

CODE AS BUILTS - FOR INFORMATION ONLY

STATUS FOR COMMENT

CLIENT

PROJECT TITLE  
MANTIS VIVARI HOTEL & SPA

DRAWING TITLE  
JALA PAVILION- BANQUET SEATING PLAN

DRAWN BY MN	CHECKED BY SG	DATE 13/03/2023
----------------	------------------	--------------------

SCALE 1:50	PROJECT NUMBER MS1100
---------------	--------------------------

DRAWING NUMBER 22008 - 100 - MSJ1104	REV A
---	----------