


JALA PAVILION CINEMA SEATING PLAN

SCALE 1:50

JALA PAVILION					
Length	10284mm	Doors	Stacking Doors, Double door	Cinema	225
Width	19220mm	Air-conditioning	Automatic	Banquet	150
Total Area	200m ²	Light Intensity	0%-100% (pre-sets)	Banquet (Dancefloor)	130
Height	4600mm	Schoolroom	150	Cocktail	180

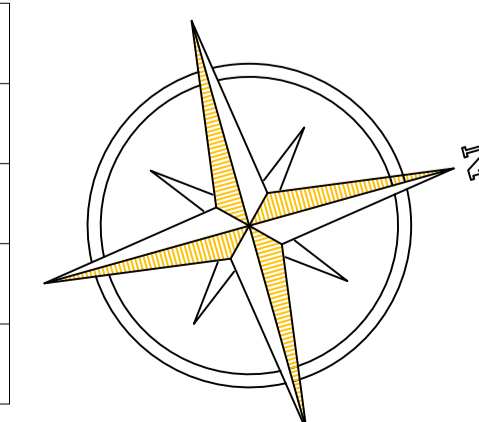

Rev	Description	Date
A	FOR INFORMATION	21.02.23

CODE AS BUILTS - FOR INFORMATION ONLY

STATUS FOR COMMENT

CLIENT

PROJECT TITLE
MANTIS VIVARI HOTEL & SPA

DRAWING TITLE
JALA PAVILION- CINEMA SEATING PLAN

DRAWN BY MN CHECKED BY SG DATE 13/03/2023

SCALE 1:50 PROJECT NUMBER MS1100

DRAWING NUMBER 22000 - 100 - MSJ1101 REV A