


**SECTION A**


SCALE 1:50

LUNA	
Length	15520mm
Width	8150mm
Total Area	125m <sup>2</sup>
Height	3100mm
Doors	Stacking Doors
Air-conditioning	Automatic
Light Intensity	0%-100% (pre-sets)
Light Facilities	0%-100% Dimmable LED Lighting
Cinema	100pax
Cocktail	120pax
Schoolroom	80pax
Banquet	100pax
Banquet (Dancefloor)	90pax
Cabaret	70pax
U-shape	40pax
Double U-shape	75pax
Carpets	Standard

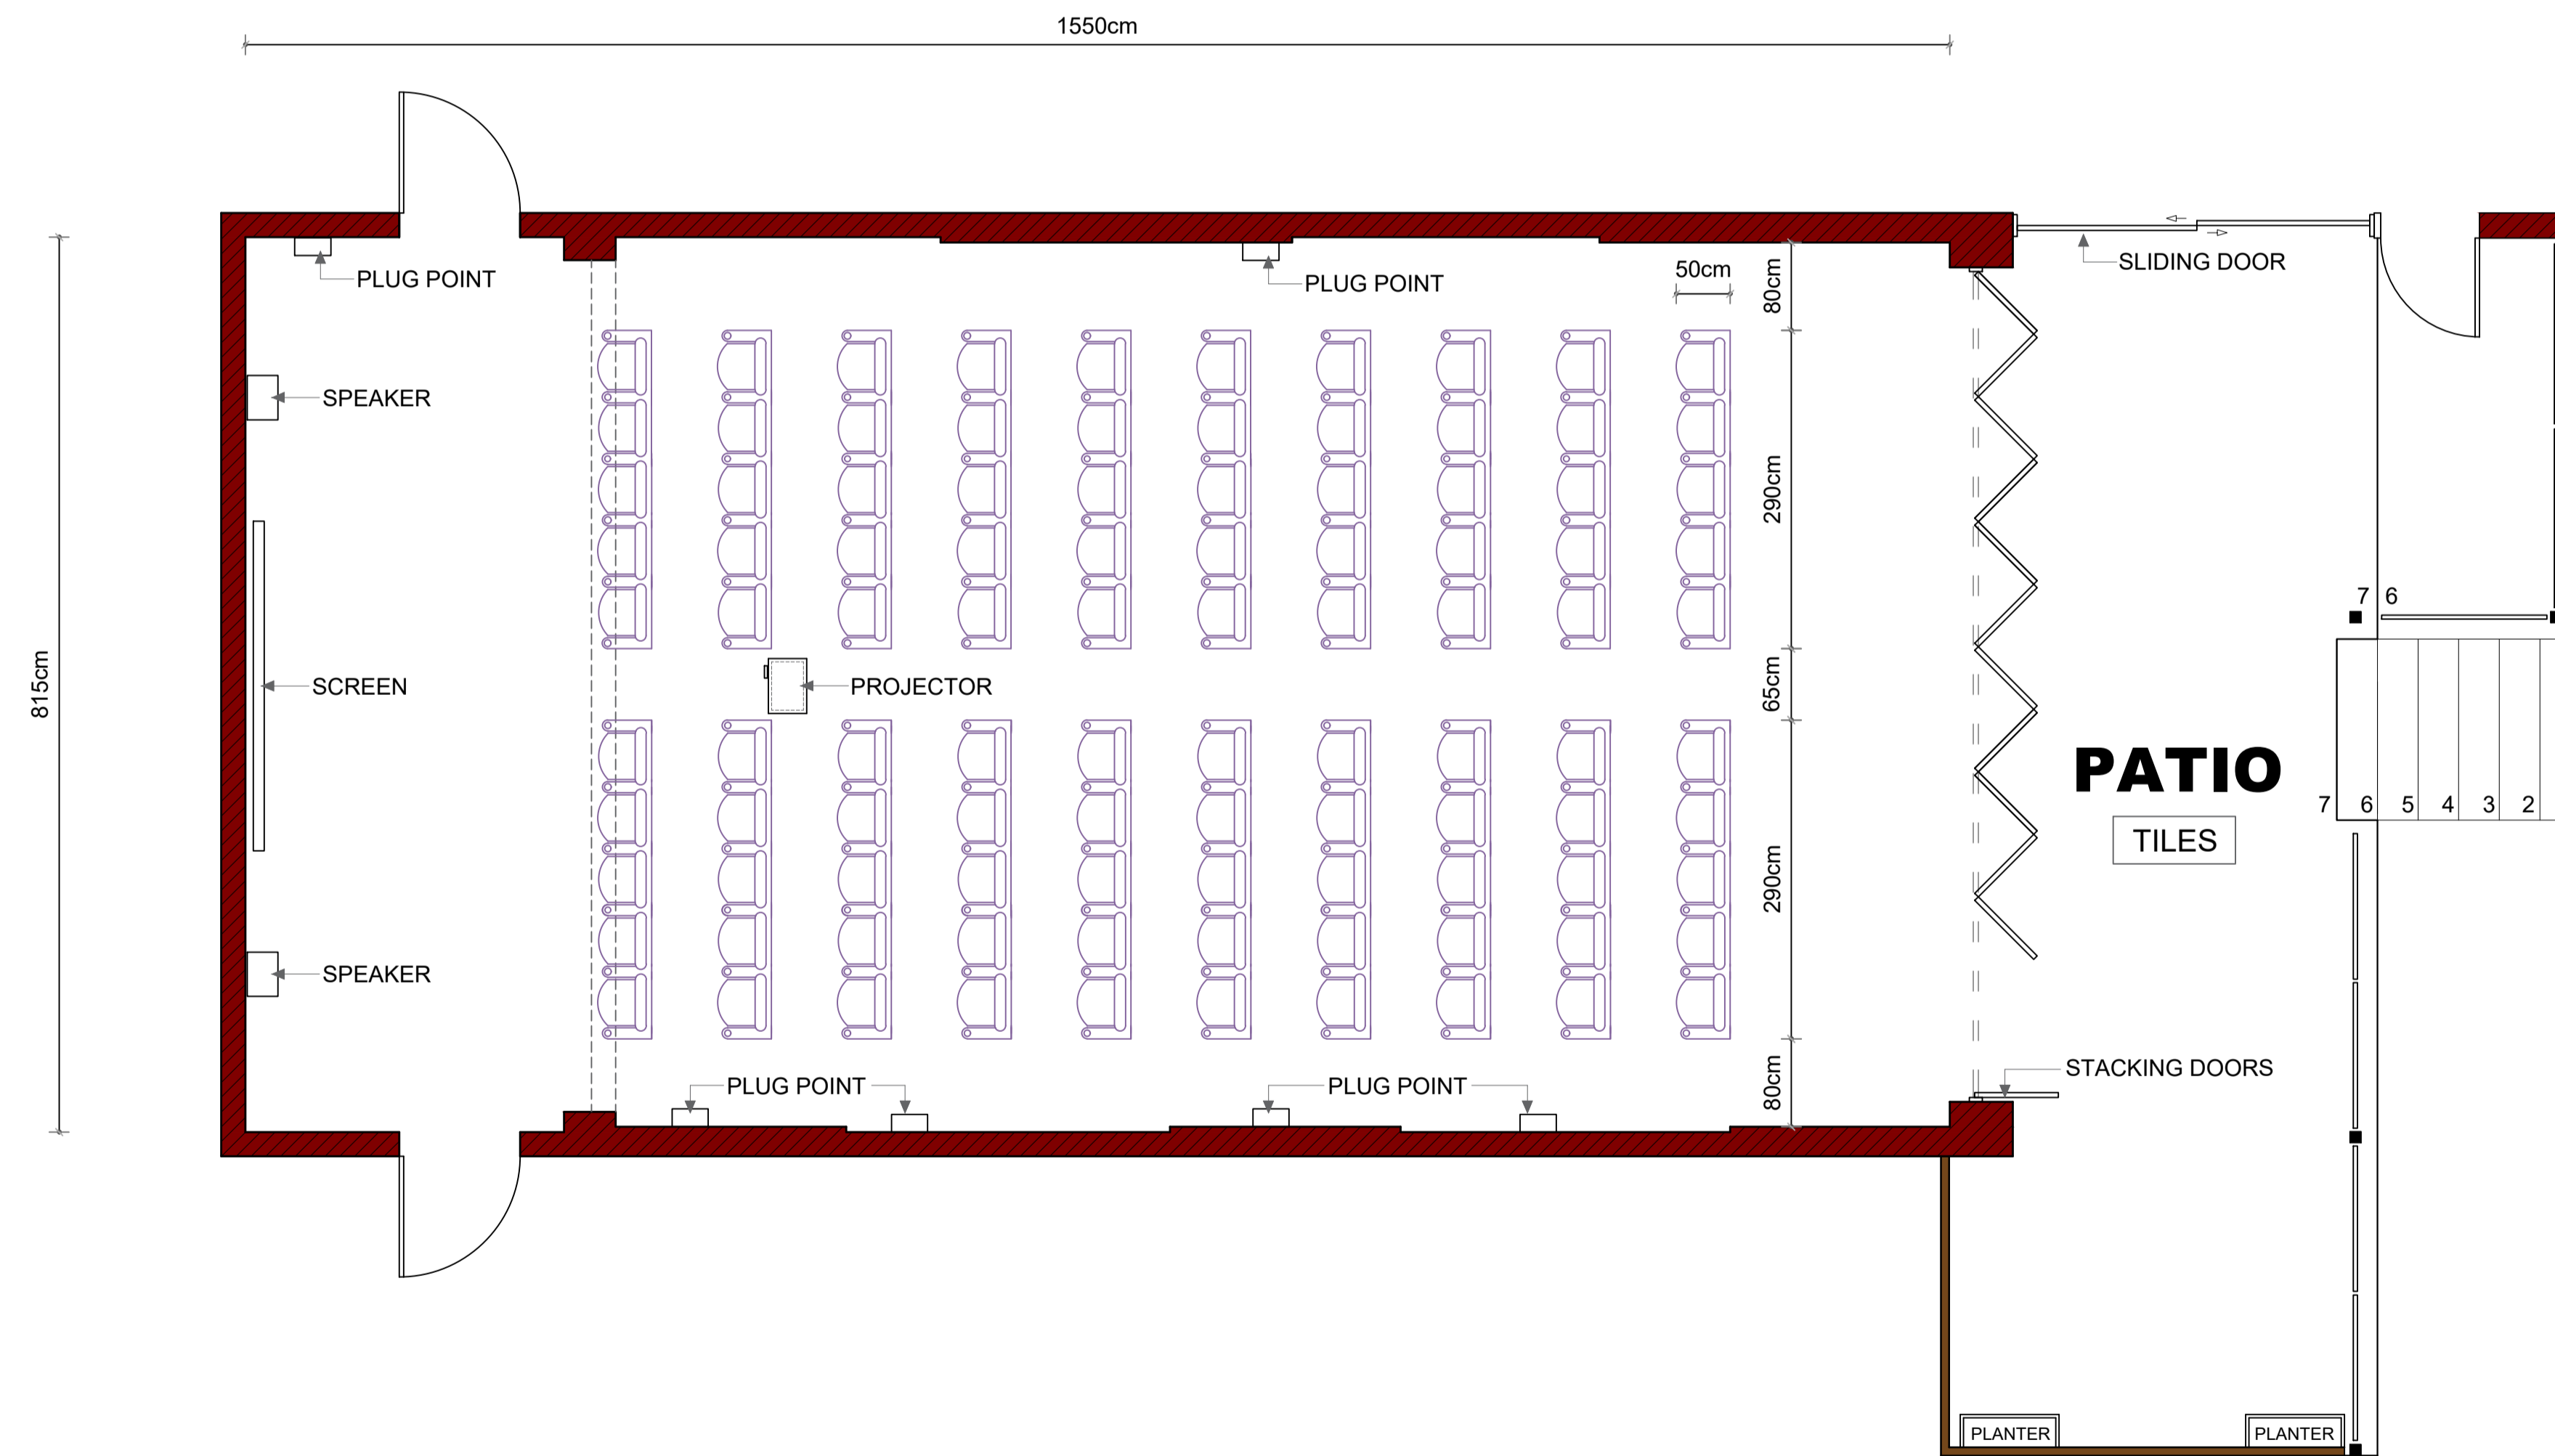

**LUNA CINEMA SEATING PLAN**

SCALE 1:50

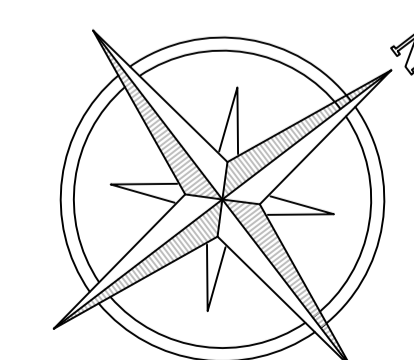

Rev	Description	Date
A	FOR INFORMATION	21.02.23

CODE AS BUILTS - FOR INFORMATION ONLY

STATUS FOR COMMENT



CLIENT  
  
**VIVARI**  
 HOTEL AND SPA

PROJECT TITLE  
**MANTIS VIVARI HOTEL & SPA**

DRAWING TITLE  
**LUNA CINEMA SEATING LAYOUT**

DRAWN BY MN CHECKED BY SG DATE 13/03/2023

SCALE 1:50 PROJECT NUMBER MS1100

DRAWING NUMBER 22009 - 100 - MSL101 REV A