


SECTION A


SCALE 1:50

| LUNA | |
|----------------------|-------------------------------|
| Length | 15520mm |
| Width | 8150mm |
| Total Area | 125m ² |
| Height | 3100mm |
| Doors | Stacking Doors |
| Air-conditioning | Automatic |
| Light Intensity | 0%-100% (pre-sets) |
| Light Facilities | 0%-100% Dimmable LED Lighting |
| Cinema | 100pax |
| Cocktail | 120pax |
| Schoolroom | 80pax |
| Banquet | 100pax |
| Banquet (Dancefloor) | 90pax |
| Cabaret | 70pax |
| U-shape | 40pax |
| Double U-shape | 75pax |
| Carpets | Standard |

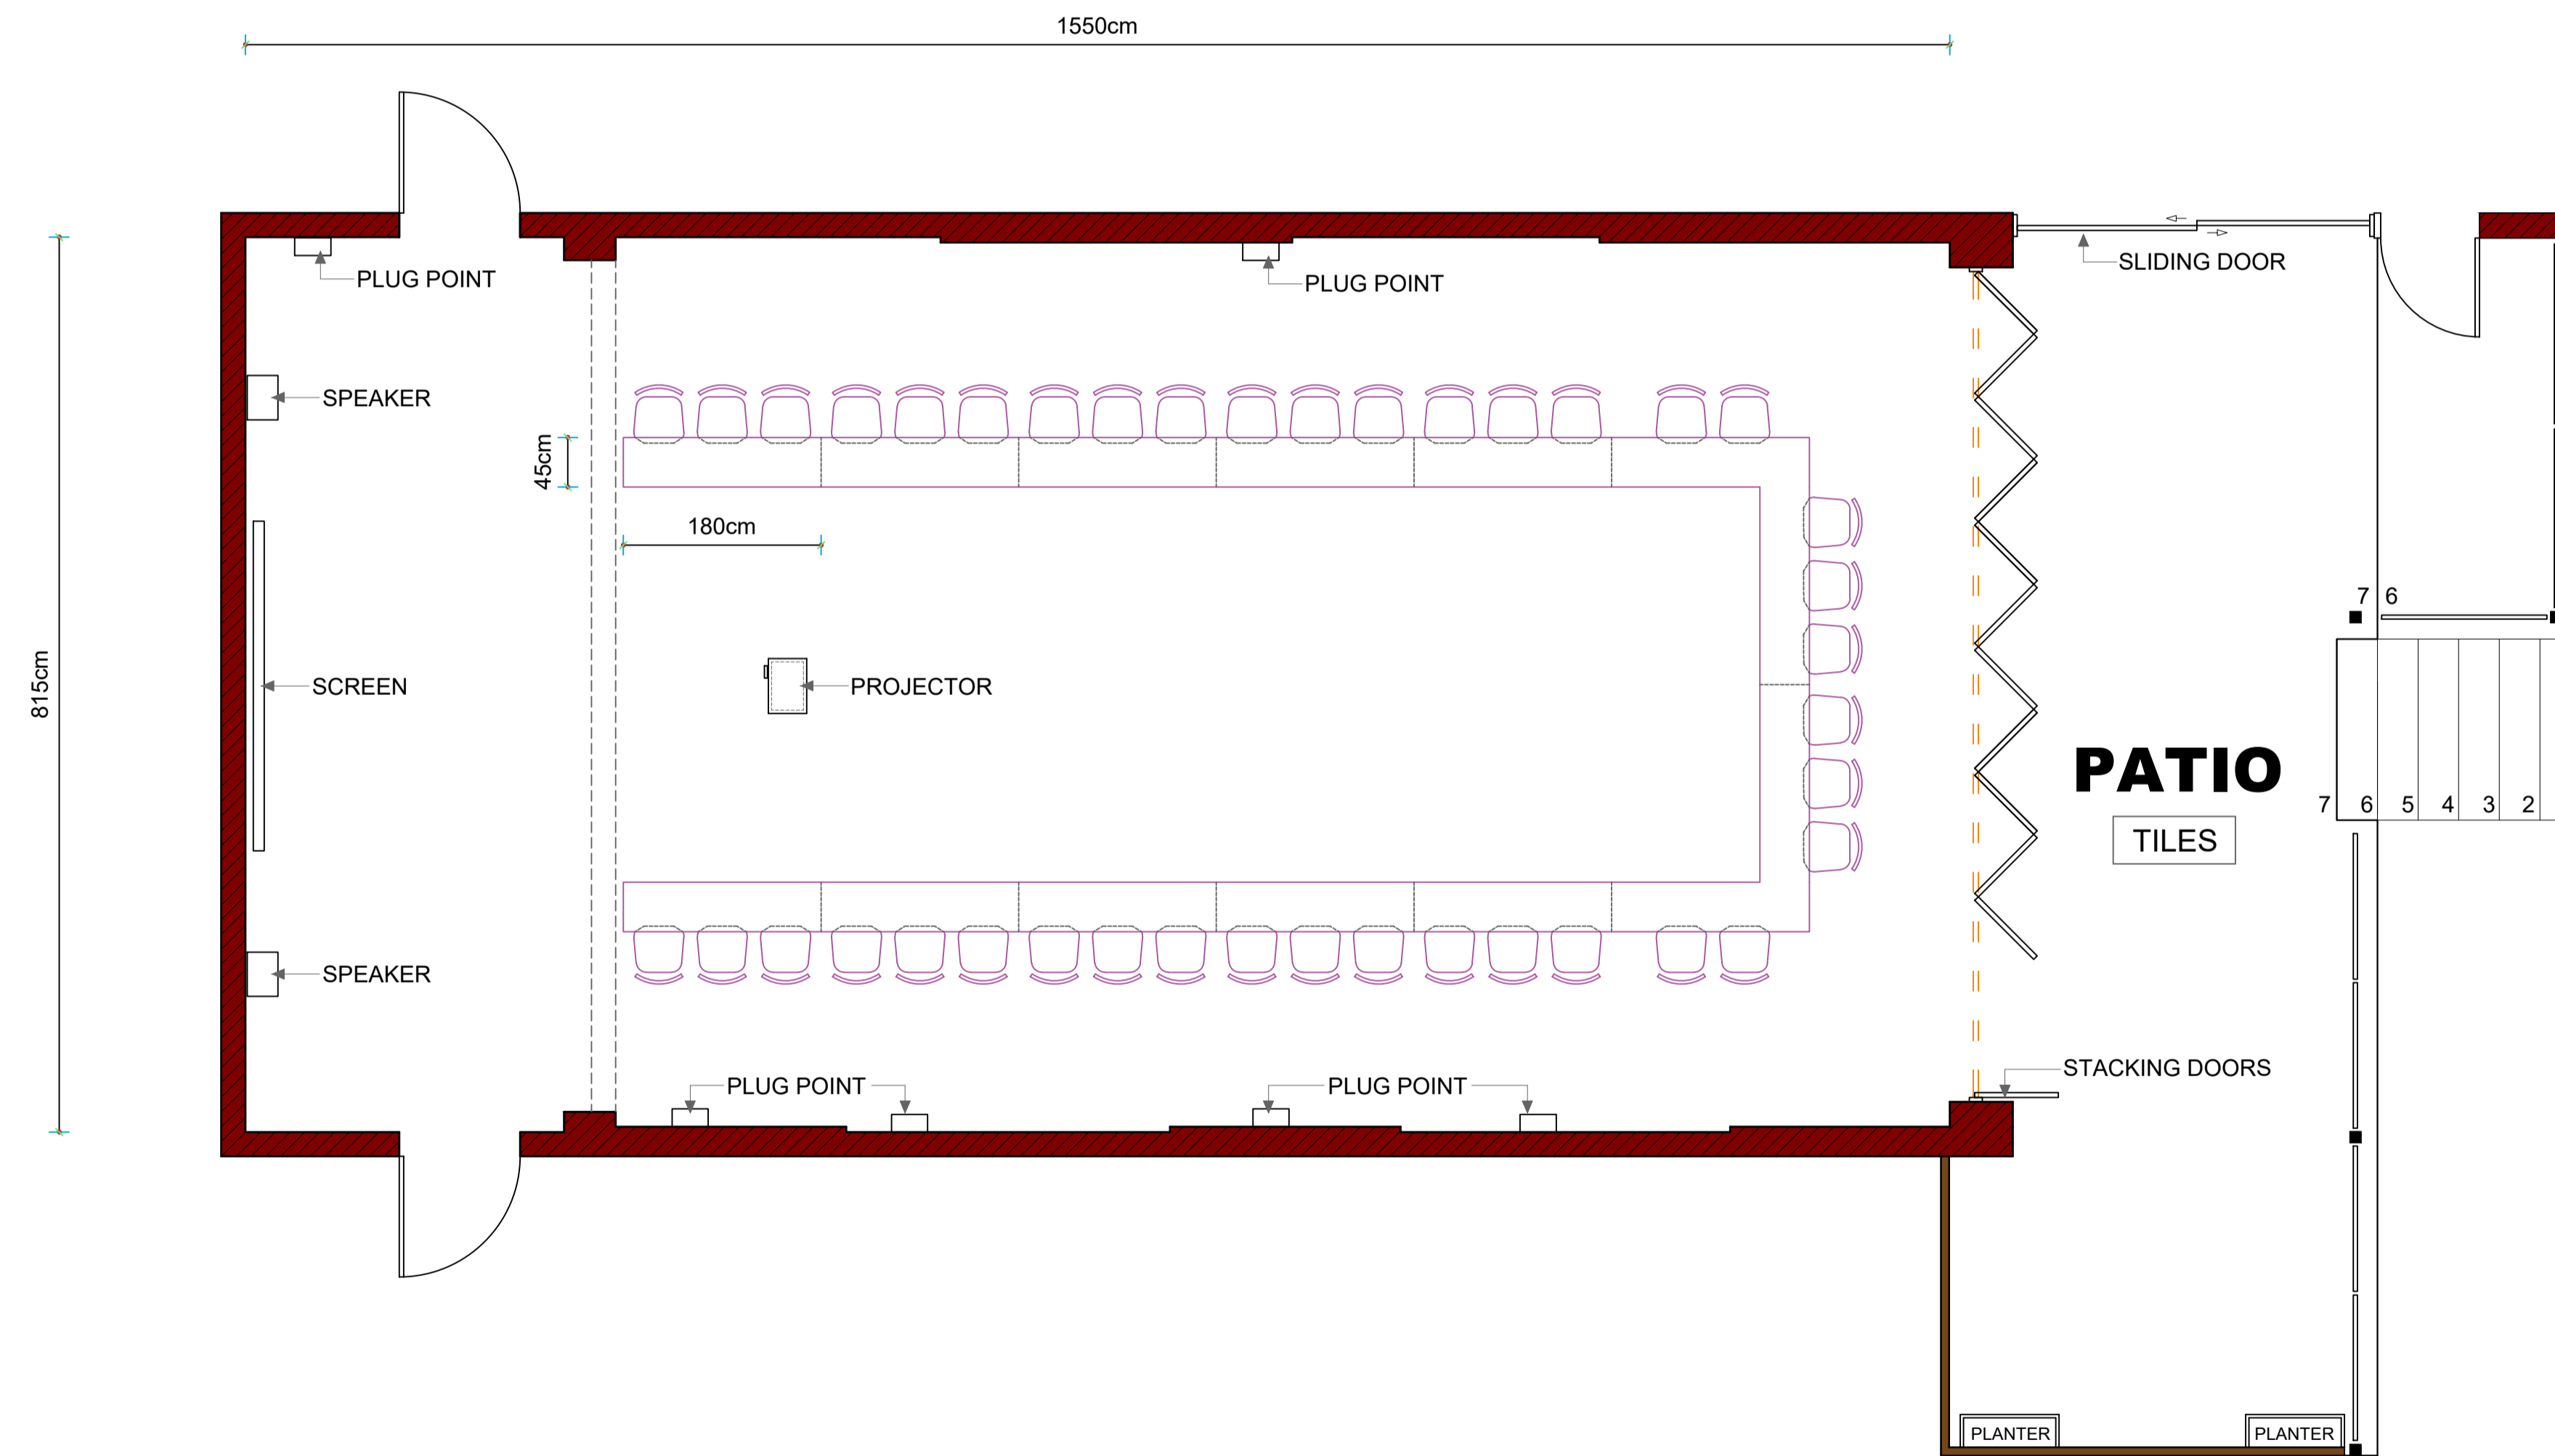

LUNA U-SHAPE SEATING PLAN

SCALE 1:50

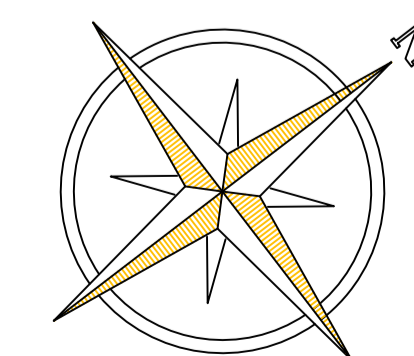

| Rev | Description | Date |
|-----|-----------------|----------|
| A | FOR INFORMATION | 21.02.23 |
| | | |
| | | |

CODE AS BUILTS - FOR INFORMATION ONLY

STATUS FOR COMMENT

CLIENT

PROJECT TITLE

MANTIS VIVARI HOTEL & SPA

DRAWING TITLE

LUNA U-SHAPE SEATING LAYOUT

DRAWN BY MN CHECKED BY SG DATE 13/03/2023

SCALE 1:50 PROJECT NUMBER MS1100

DRAWING NUMBER 22008 - 100 - MSL107 REV A