



25896														
200				19220				230	3250	230	2550	230		
200	4691	200	4605	200	4605	200	4705	230	3250	230	1185	115	1250	230

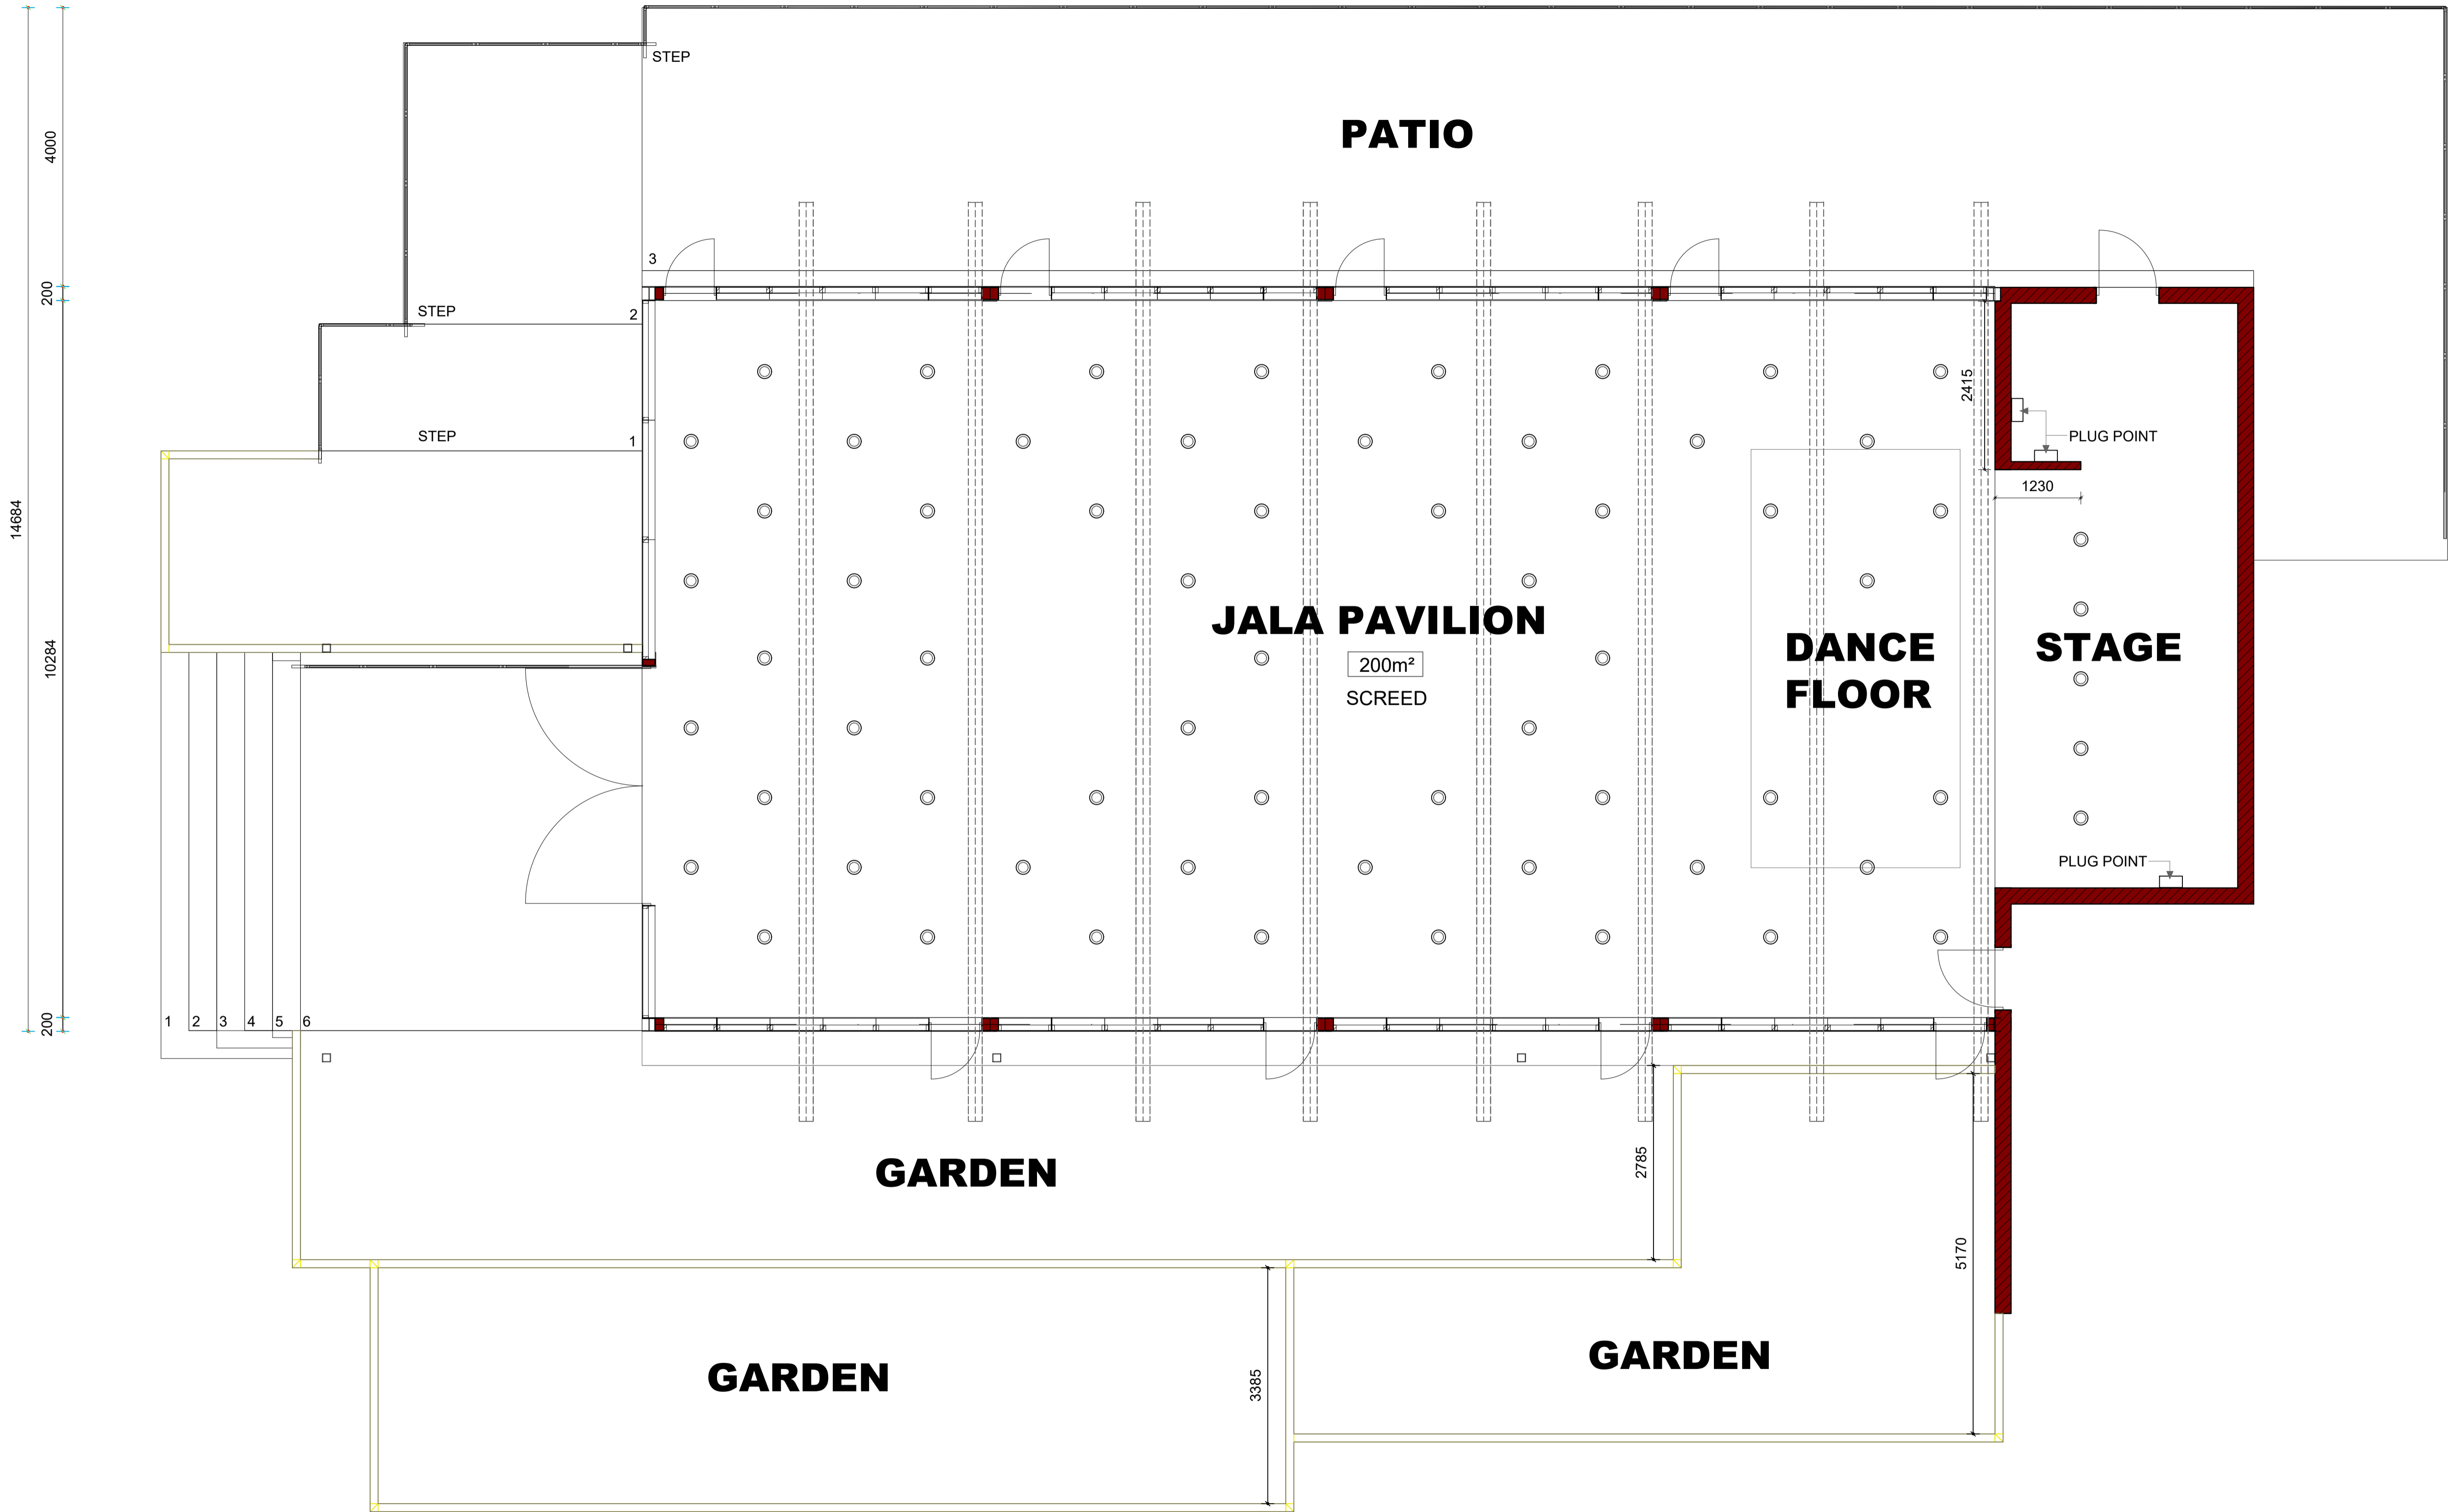

# JALA PAVILION

SCALE 1:50

JALA PAVILION					
Length	10284mm	Doors	Stacking Doors, Double door	Cinema	225
Width	19220mm	Air-conditioning	Automatic	Banquet	150
Total Area	200m²	Light Intensity	0%-100% (pre-sets)	Banquet (Dancefloor)	130
Height	4600mm	Schoolroom	150	Cocktail	180

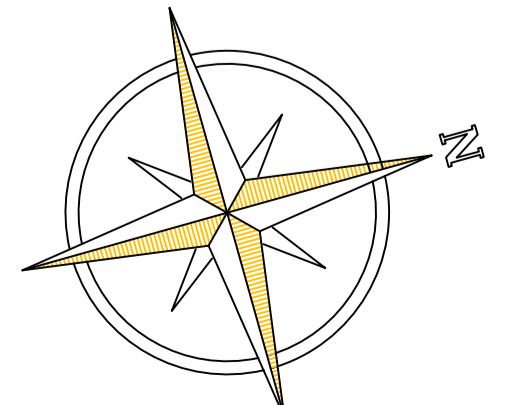

Rev	Description	Date
A	FOR INFORMATION	21.02.23

CODE: AS BUILTS - FOR INFORMATION ONLY  
 STATUS: FOR COMMENT

CLIENT

PROJECT TITLE  
 MANTIS VIVARI HOTEL & SPA

DRAWING TITLE  
 JALA PAVILION- FLOOR PLAN LAYOUT

DRAWN BY	CHECKED BY	DATE
MN	SG	20/02/2023

SCALE	PROJECT NUMBER
1:50	MS1100

DRAWING NUMBER: 22000 - 100 - MS1103      REV: A